

D&C SURVEYING PTY LTD
ABN 99 080 346 961
LAND & ENGINEERING SURVEYORS

Suite 3, 267-277 Norton St
LEICHHARDT NSW 2040
Tel/fax 02 9568-6918
dcsurveying@bigpond.com

SURVEY REPORT

Date: 17-10-2014
Our reference: 282-14
Parties: Danny Coral

Details of land development

Address: 11 Colane Street Concord West NSW 2138
Title: Lot 27 Sec H DP 10188
DA: 514/07

Description of the development: **Construction of Two Storey Brick Dwelling**

Survey Certification as per DA requirements: - **Building Location**
- **Reduced Floor Levels**

Walls at the ground level of the Two Storey Brick Dwelling stand wholly within the confines of the subject property, as shown upon the sketch herewith.


As built levels are as follows:

Garage FFL=8.13
Ground Floor FL=8.24
First Floor FL=11.28
Roof Ridge RL=15.72

Full details in relation thereto are shown edged red on the adjoining sketch.

This report is provided for the sole use of the above named applicant and Principal Certifying Authority and no other party may rely on the same.


For and on Behalf of
D&C Surveying Pty Ltd

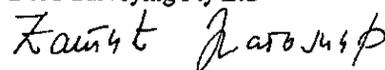

Dragomir Catic (BE MIS NSW)
Registered Surveyor (8671)

FINAL SURVEY - WORK AS EXECUTED

DC

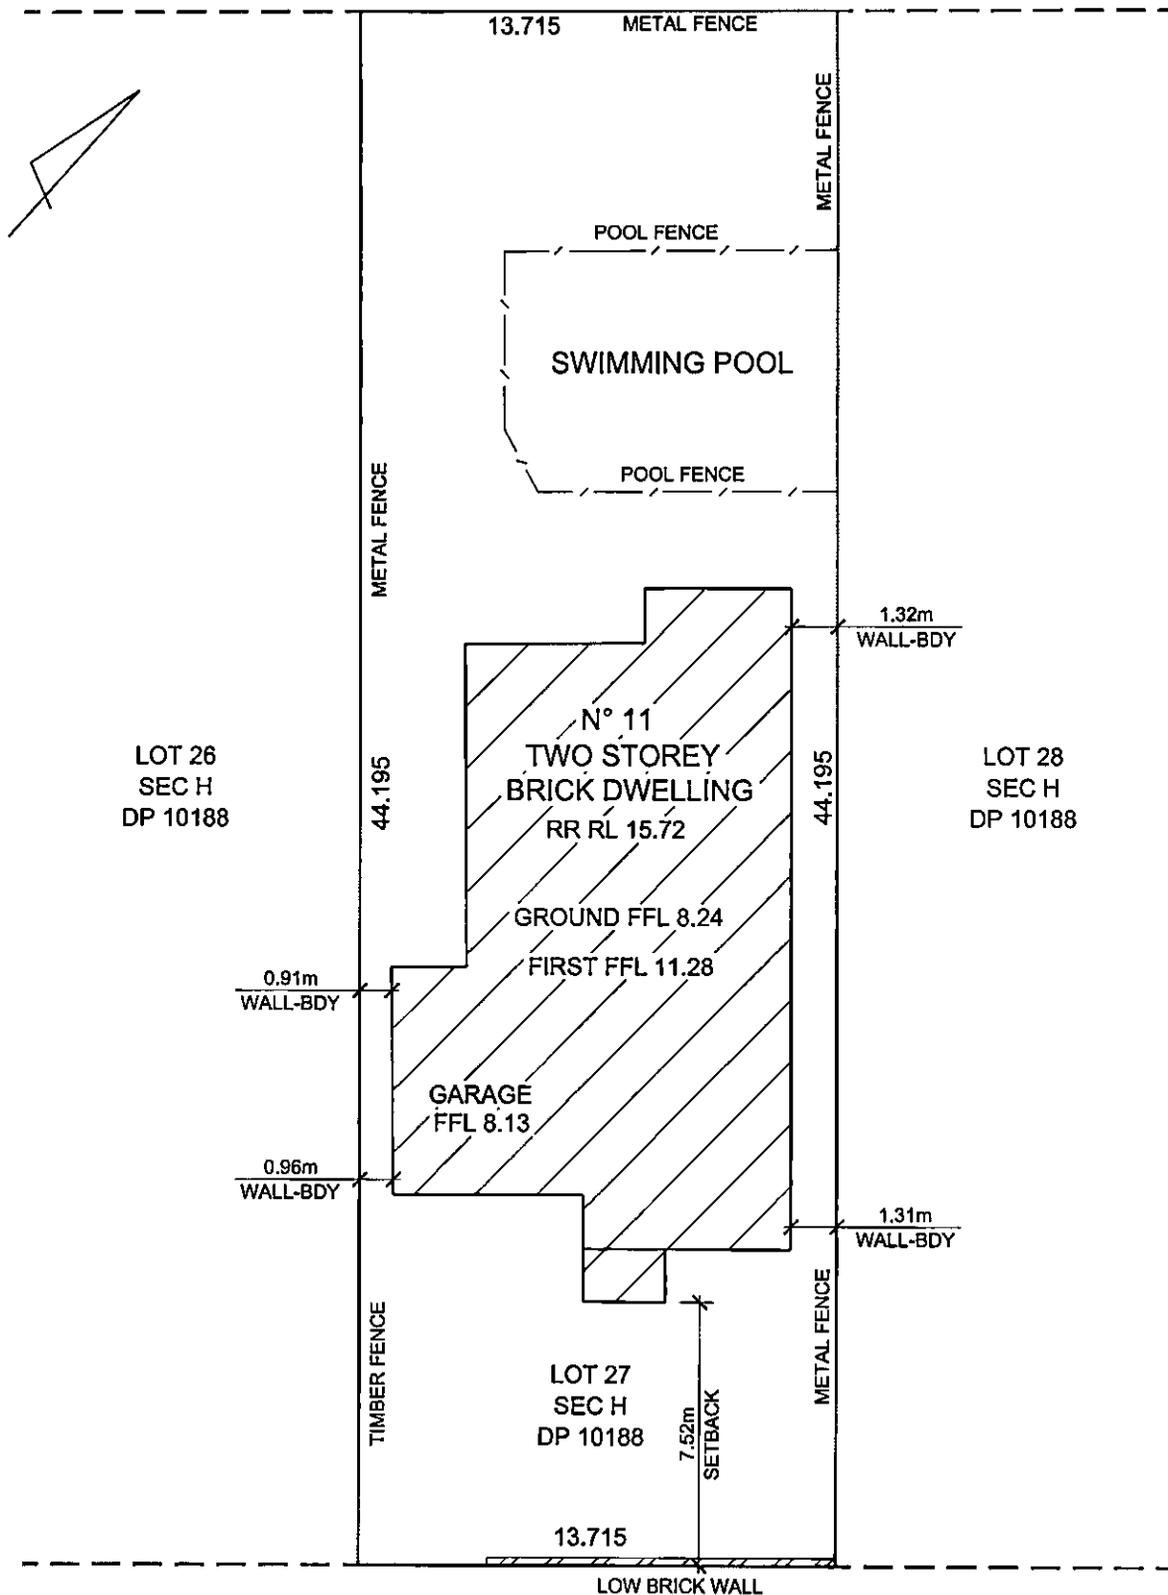

COLANE STREET

For and on behalf of
D&C SURVEYING PTY LTD

Dragomir Catich

DRAGOMIR CATICH (BE MIS NSW)
REGISTERED SURVEYOR (8671)

DATE: 17-10-2014